


YORK STATION

YORKTON, SK

BUILDING 2
UNIT 3

3,613
SQUARE FEET

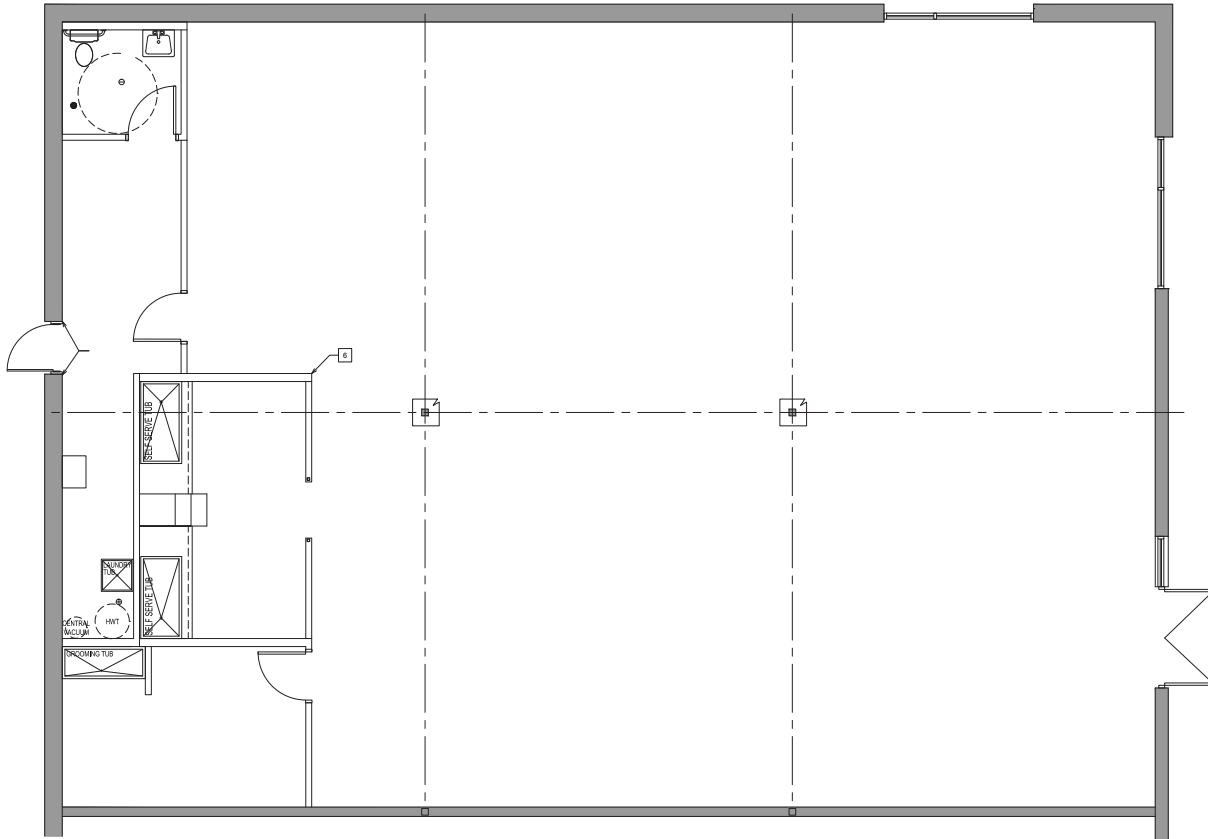

AVAILABLE MARCH 2025

Space plans and as builts are approximate and may be subject to change. All drawings should be independently verified.



COLIN PETER

DIRECTOR OF LEASING

T | 403.268.6640 **E** | cpeter@harvard.ca

RYANN BRAATEN

LEASING MANAGER

T | 306.777.0690 **E** | rbraaten@harvard.ca